

10/758,742


REMARKS

The drawings are amended, per the attached Submission, to overcome a few noted informalities contained therein, e.g., to remove the sheet number and correctly identify new Figs. 6-15. If any further amendment to the drawings is believed necessary, the Examiner is invited to contact the undersigned representative of the Applicant to discuss the same.

The Applicant respectfully requests that any outstanding objection(s) or requirement(s), as to the form of this application, be held in abeyance until allowable subject matter is indicated for this case.

In the event that there are any fee deficiencies or additional fees are payable, please charge the same or credit any overpayment to our Deposit Account (Account No. 04-0213).

Respectfully submitted,

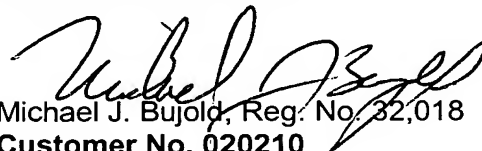

Michael J. Bujold, Reg. No. 32,018

Customer No. 020210

Davis & Bujold, P.L.L.C.

112 Pleasant Street

Concord, NH 03301-2931

Telephone 603-226-7490

Facsimile 603-226-7499

E-mail: patent@davisandbujold.com

Annotated Marked-Up Drawing



~~1/3~~

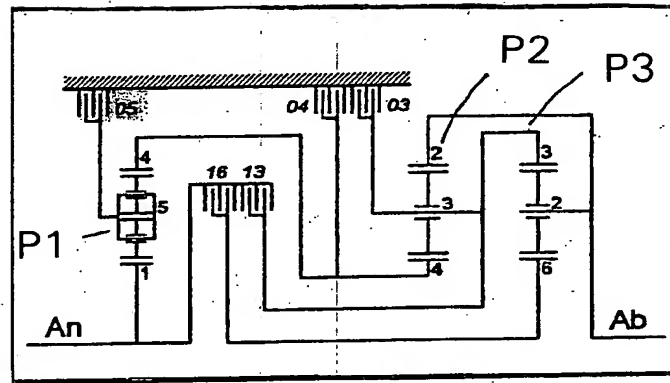


Fig. 1

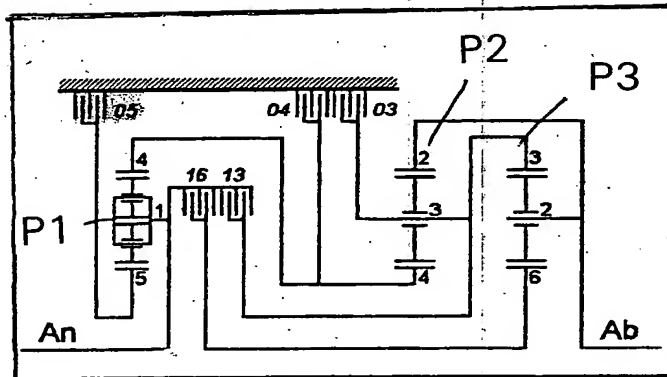


Fig. 2

~~2/3~~

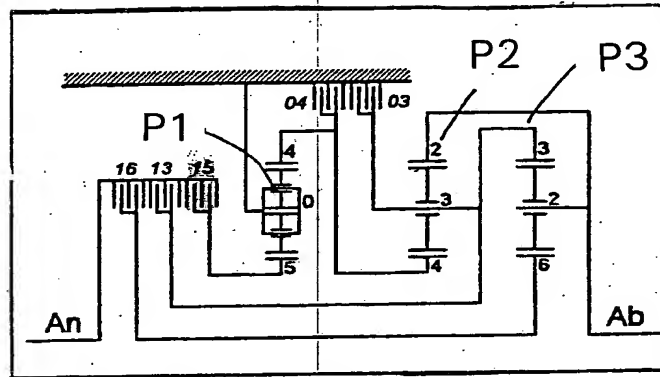


Fig. 3

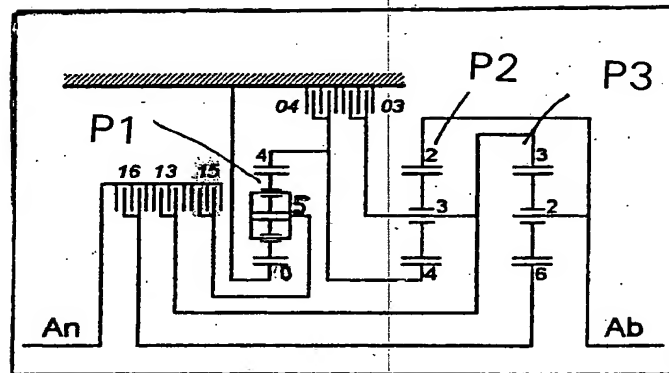


Fig. 4

Annotated Marked-Up Drawing

~~3/3~~

	03	04	13	16	⁰⁵ 15	i	φ
1.	•			•		3,842	1,854
2.		•		•		2,073	1,405
3.				•	•	1,475	1,475
4.			•	•		1,000	1,377
5.			•		•	0,726	1,166
6.		•	•			0,623	1,000
R.	•				•	-4,373	

Fig. 5